



March 17, 2020

ADDENDUM #2
NWIT-20-01
Wayfinding - New Westminister Public Library
716 Sixth Avenue, New Westminister, BC

This addendum modifies the Invitation to Tender only as noted:

INSTRUCTION TO BIDDERS

1.0 Scope of Work

<ADD>

- “1.2 The work involves the removal of existing signs in all locations where the new signs are scheduled to be located, for the same function. Bidders are to include this Work in the Offer Price.
- 1.3 There is no parking available on site for the contractor. Offsite parking will be required and will be the responsibility of the contractor.
- 1.4 Loading and unloading are to be completed only at the loading dock located at the southeast corner of the building. Loading/unloading dates and times and access to the building is to be arranged by the contractor with the Deputy Chief Librarian.
- 1.5 Installation of signage can be conducted during normal Library opening hours - Weekdays 9:30 am – 9:00 pm, Saturdays 9:30 am – 6:00 pm and Sundays 12:00 noon – 5:00 pm. Noisy work such as drilling, power screwing, power cutting and hammering must be conducted outside the opening hours, subject to prior written arrangement with the Deputy Chief Librarian.
- 1.6 Wall and elevator doors and frames are painted in latex, MPI INT 9.2A, gloss level G3 (eggshell).
- 1.7 The Owner’s preferred fabricators are provided on list (attached) for information to the bidders. Should a bidder wish to use a different fabrication company, the bidder is to provide the name of the company and at least three (3) completed project examples and contact names and numbers, at least 5 working days prior to tender closing.”

3.0 Submission of Tender

3.1 <CHANGE TO READ>

“Bidders shall submit the Tender on the enclosed Bid Form”

3.2 <CHANGE TO READ>

“The completed Tender shall be submitted by email to nwpurchasing@newwestcity.ca with a subject line of BID – NWIT-20-01 Wayfinding - New Westminster Public Library.”

3.5 <CHANGE TO READ>

“The City does not accept facsimile or other unsealed bids. For this Invitation to Tender, the City will accept electronic mail submissions to the email address in 3.2 above.”

3.6 <CHANGE TO READ>

“The City **will not** accept or consider late submissions.”

16.0 Bid Security, Performance Bonding and Guarantees

16.1 <CHANGE TO READ>

Bid Security and Performance Bonding is not required for this Tender.

<DELETE>

Paragraphs 16.2, 16.3, 16.4, and 16.5

CLARIFICATION

Please refer to information regarding hazmat content of walls and furring (2 pages following)

Please acknowledge this addendum on page 3 of 4 in the Bid Form.

END OF ADDENDUM # 2

Yours truly,



Heather M. Rossi
Intermediate Buyer
email: hrossi@newwestcity.ca



Local Fabricators

19.11.06

RICK WAY | Senior VP Sales
EEC Industries
E: r-way@eecind.com
P: 604.986.5633
1237 Welch Street,
North Vancouver, BC, V7P 1B3
eecind.com/

BROOKS AMOS | Account Manager
Innovative Signage
A Division of Ampco Manufacturers Inc.
E. brooks.amos@innovativesignage.com
Direct Line: 604.998.0822
P: 604.984.4395
F: 604.984.4495
Unit 208-1075 West 1st Street,
North Vancouver, BC, V7P 3T4
innovativesignage.com

PAUL BATTS
Multigraphics Ltd.
E: praul@multigraphics.ca
P: 604.437.8444
C: 604.353.5677
3823 Still Creek Ave,
Burnaby, BC, V5C 4E2
multigraphics.ca

If the fabricators require hiring a wood subcontractor, PUBLIC recommends Schrapnel Design.

JEREMY VAN NIEUWKERK
Schrapnel Design
E. jeremy@shrapneldesign.com
P: 604.568.7280
C: 778.231.2373
936 Clark Drive, Vancouver BC
shrapneldesign.com



RECORD DRAWINGS
 ALL AS-BUILT INFORMATION INDICATED ON THESE DRAWINGS HAS BEEN PROVIDED BY THE CONTRACTOR. THE ARCHITECT ASSUMES NO RESPONSIBILITY FOR THE ACCURACY OF THE INFORMATION PROVIDED BY THE CONTRACTOR.

All plans, sketches, drawings, graphic representations and specifications prepared by David Norman Architect Inc. are instruments of service for carrying out a project. David Norman Architect Inc. retains copyright in these plans, sketches, drawings, graphic representations and specifications, which may not be used for any other project without the written consent of David Norman Architect Inc.


REFERENCE DRAWINGS
 THESE REFERENCE DRAWINGS ARE BASED ON SITE OBSERVATIONS, MEASURED CAD DRAWINGS PROVIDED BY THE CITY OF VANCOUVER, AND TOPOGRAPHY BY WATSON & BARNARD SURVEYORS DATED JAN 20 2010. DAVID NORMAN ARCHITECT INC. IS NOT RESPONSIBLE FOR THE ACCURACY OF DRAWINGS PREPARED BY OTHERS.

LEGEND:

- BS = Asbestos Bulk Sample Locations
- LS = Lead Sample Locations
- X = Location Number



NOTE 1: DRYWALL OR FURRING OR STUDS MAY CONTAIN ASBESTOS MATERIALS AND/OR LEAD CONTAINING PAINT. REFER TO HAZARDOUS MATERIALS ASSESSMENT REPORT.

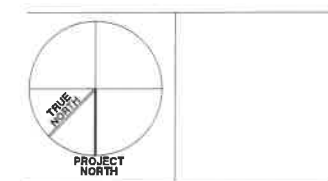

PROJECT:
NEW WESTMINSTER PUBLIC LIBRARY

716 SIXTH AVE.
 NEW WESTMINSTER, BC

DRAWING:
SECOND FLOOR HBMA SAMPLE LOCATIONS

PROJECT NO.: 19200W	CHECKED BY: RK
DATE: 2010/02/26	SCALE: Not to Scale

DRAWING NO.:




RECORD DRAWINGS
 ALL AS-BUILT INFORMATION INDICATED ON THESE DRAWINGS HAS BEEN PROVIDED BY THE CONTRACTOR. THE ARCHITECT ASSUMES NO RESPONSIBILITY FOR THE ACCURACY OF THE INFORMATION PROVIDED BY THE CONTRACTOR.

All plans, sketches, drawings, graphic representations and specifications prepared by David Norman Architect Inc. are instruments of service for carrying out a project. David Norman Architect Inc. retains copyright in these plans, sketches, drawings, graphic representations and specifications, which may not be used for any other project without the written consent of David Norman Architect Inc.


REFERENCE DRAWINGS
 THESE REFERENCE DRAWINGS ARE BASED ON SITE OBSERVATIONS. THESE REFERENCE DRAWINGS ARE PROVIDED BY THE CITY & THE PLAN OF TOPOGRAPHY BY WATSON & BARNARD SURVEYORS DATED JAN. 25, 2012. DAVID NORMAN ARCHITECT INC. IS NOT RESPONSIBLE FOR THE ACCURACY OF DRAWINGS PREPARED BY OTHERS.

LEGEND:

- BS = Asbestos Bulk Sample Locations
- LS = Lead Sample Locations
- X = Location Number

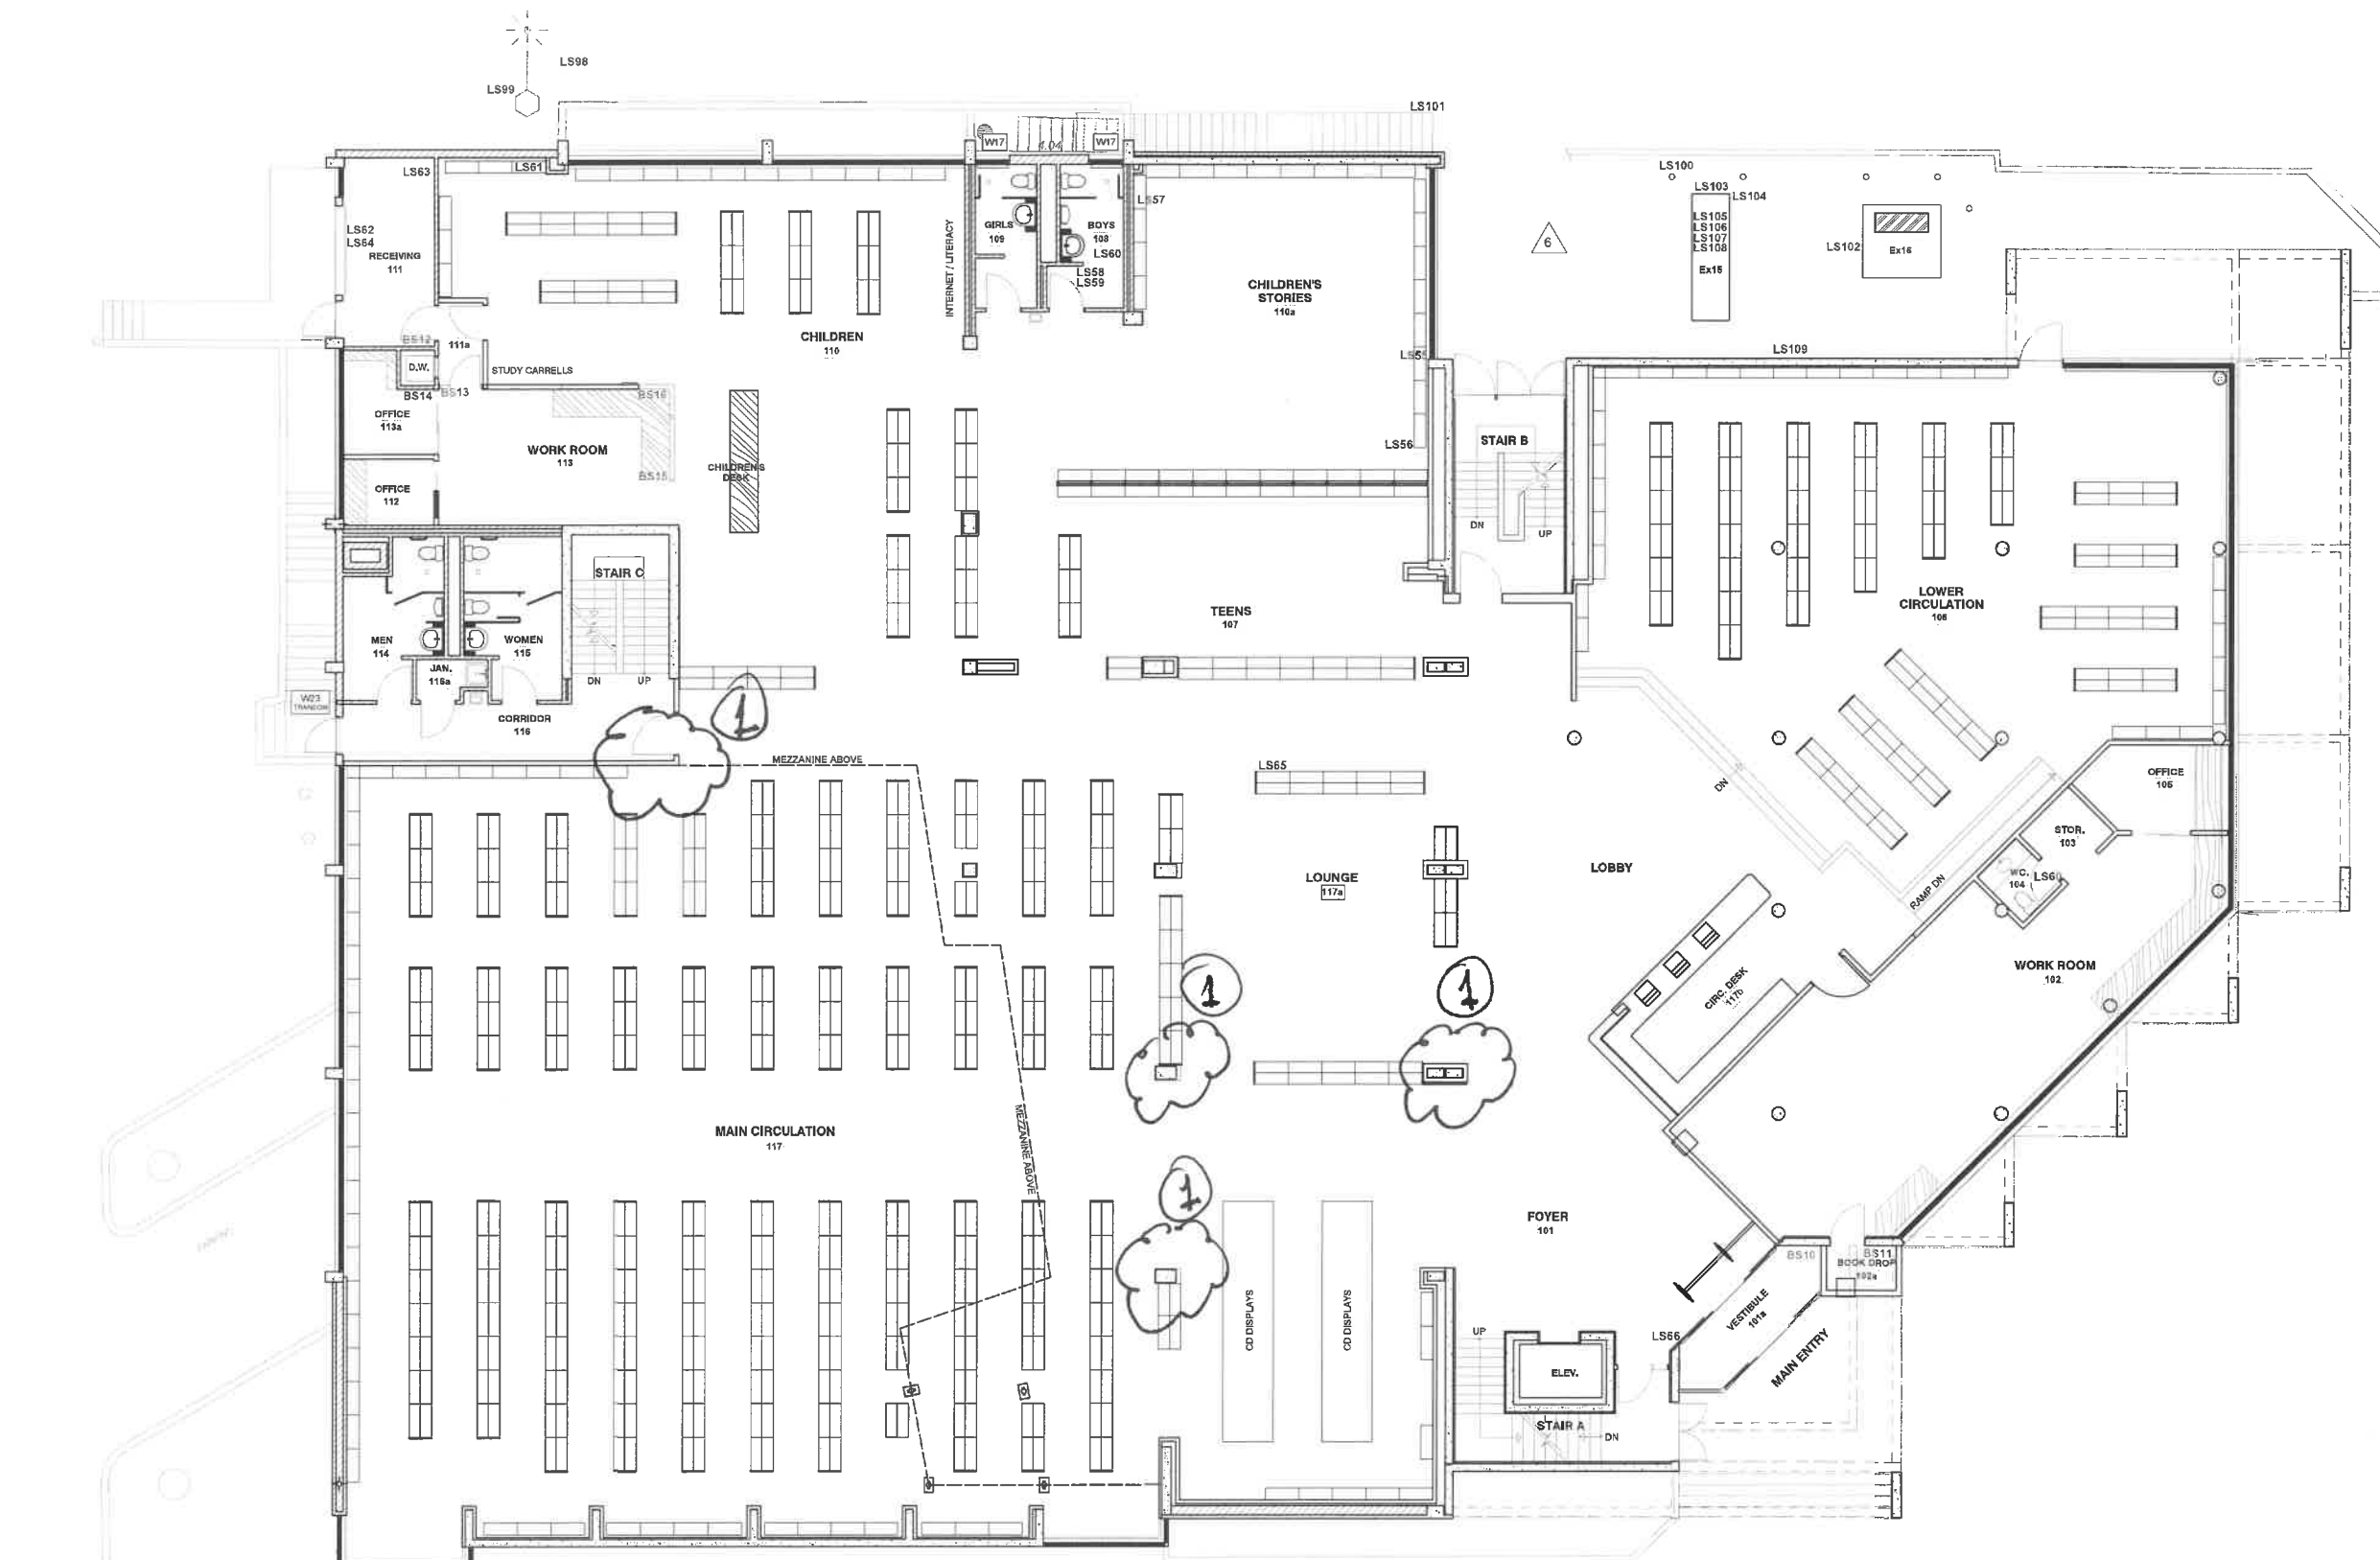

NOTE 1 : DRYWALL ON FURRING MAY CONTAIN ASBESTOS MATERIALS AND/OR LEAD CONTAINING PAINT. REFER TO HAZARDOUS MATERIALS ASSESSMENT REPORT.

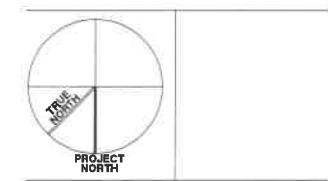

PROJECT:
NEW WESTMINSTER PUBLIC LIBRARY

716 SIXTH AVE.
 NEW WESTMINSTER, BC

DRAWING:
MAIN FLOOR HBMA SAMPLE LOCATIONS

PROJECT NO.: 18200W	CHECKED BY: RK
DATE: 2019/09/26	SCALE: Not to Scale